

Textron, Inc.
Former Gorham Manufacturing Facility, Providence, RI
Remedial Action Completion Report: Phase II Area – Mashapaug Inner Cove,
Phase III Area – Northeast Upland And Parcel C
Project No.: 3652160001
February 12, 2016



APPENDIX M
AS-BUILT DOCUMENTATION



50' PERIMETER WETLAND BUFFER



LEGEND

- 60.00 — AS-BUILT MAJOR CONTOUR
- AS-BUILT MINOR CONTOUR
- - - 50' PERIMETER WETLAND BUFFER
- LOD — LIMIT OF DISTURBANCE
- ~ TREELINE
- × 60.00 SPOT GRADE IN COVE
- ⊕ MONITORING WELL
- UPLAND CAP
- PERIMETER WETLAND CAP
- FRINGE WETLAND CAP
- INNER COVE CAP

MW-243
TOP OF MW = EL. 43.04'
SPOT GRADE = EL. 40.25'
SEE NOTE 2.

BENCHMARK USED:
"X" CUT IN HYDRANT
EL. = 67.39'

MW-241
TOP OF PIPE = EL. 60.36'
SPOT GRADE = EL. 60.91'
SEE NOTE 2.


UPLAND CAP,
TYP.

NOTES:


1. AS-BUILT DATA WAS RECORDED BY CHARTER CONTRACTING COMPANY, L.L.C. ON DECEMBER 17, 2015, JANUARY 13, 2016, AND JANUARY 29, 2016 USING A NUBBLE GPS ROVER. SURVEY BASED ON THE RHODE ISLAND NAD83 STATE COORDINATE SYSTEM. BENCHMARK USED FOR SURVEY CONTROL WAS "X" CUT INTO HYDRANT AT ELEVATION 67.39'.
2. LOCATIONS AND ELEVATIONS OF MONITORING WELLS MW-241 AND MW-243 WERE SURVEYED ON JANUARY 29, 2016 BY CHARTER. MW-241 ELEVATION SHOWN REPRESENTS TOP OF PIPE. MW-243 WAS LOCKED AND THE ELEVATION SHOWN REPRESENTS THE WELL CAP.

FIGURE 1
PARCEL C
AS-BUILT PLAN
 TEXTRON FORMER GORHAM SITE
 PROVIDENCE, RHODE ISLAND
 FEBRUARY 1, 2016

Charter PROJECT #: 2-1244
 DRAWN BY: S. GRAY
 500 HARRISON AVE. APPROVED BY: P. LEFANTI
 BOSTON, MA 02118
 857.246.6800

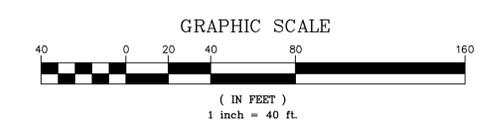

DATE	REVISIONS

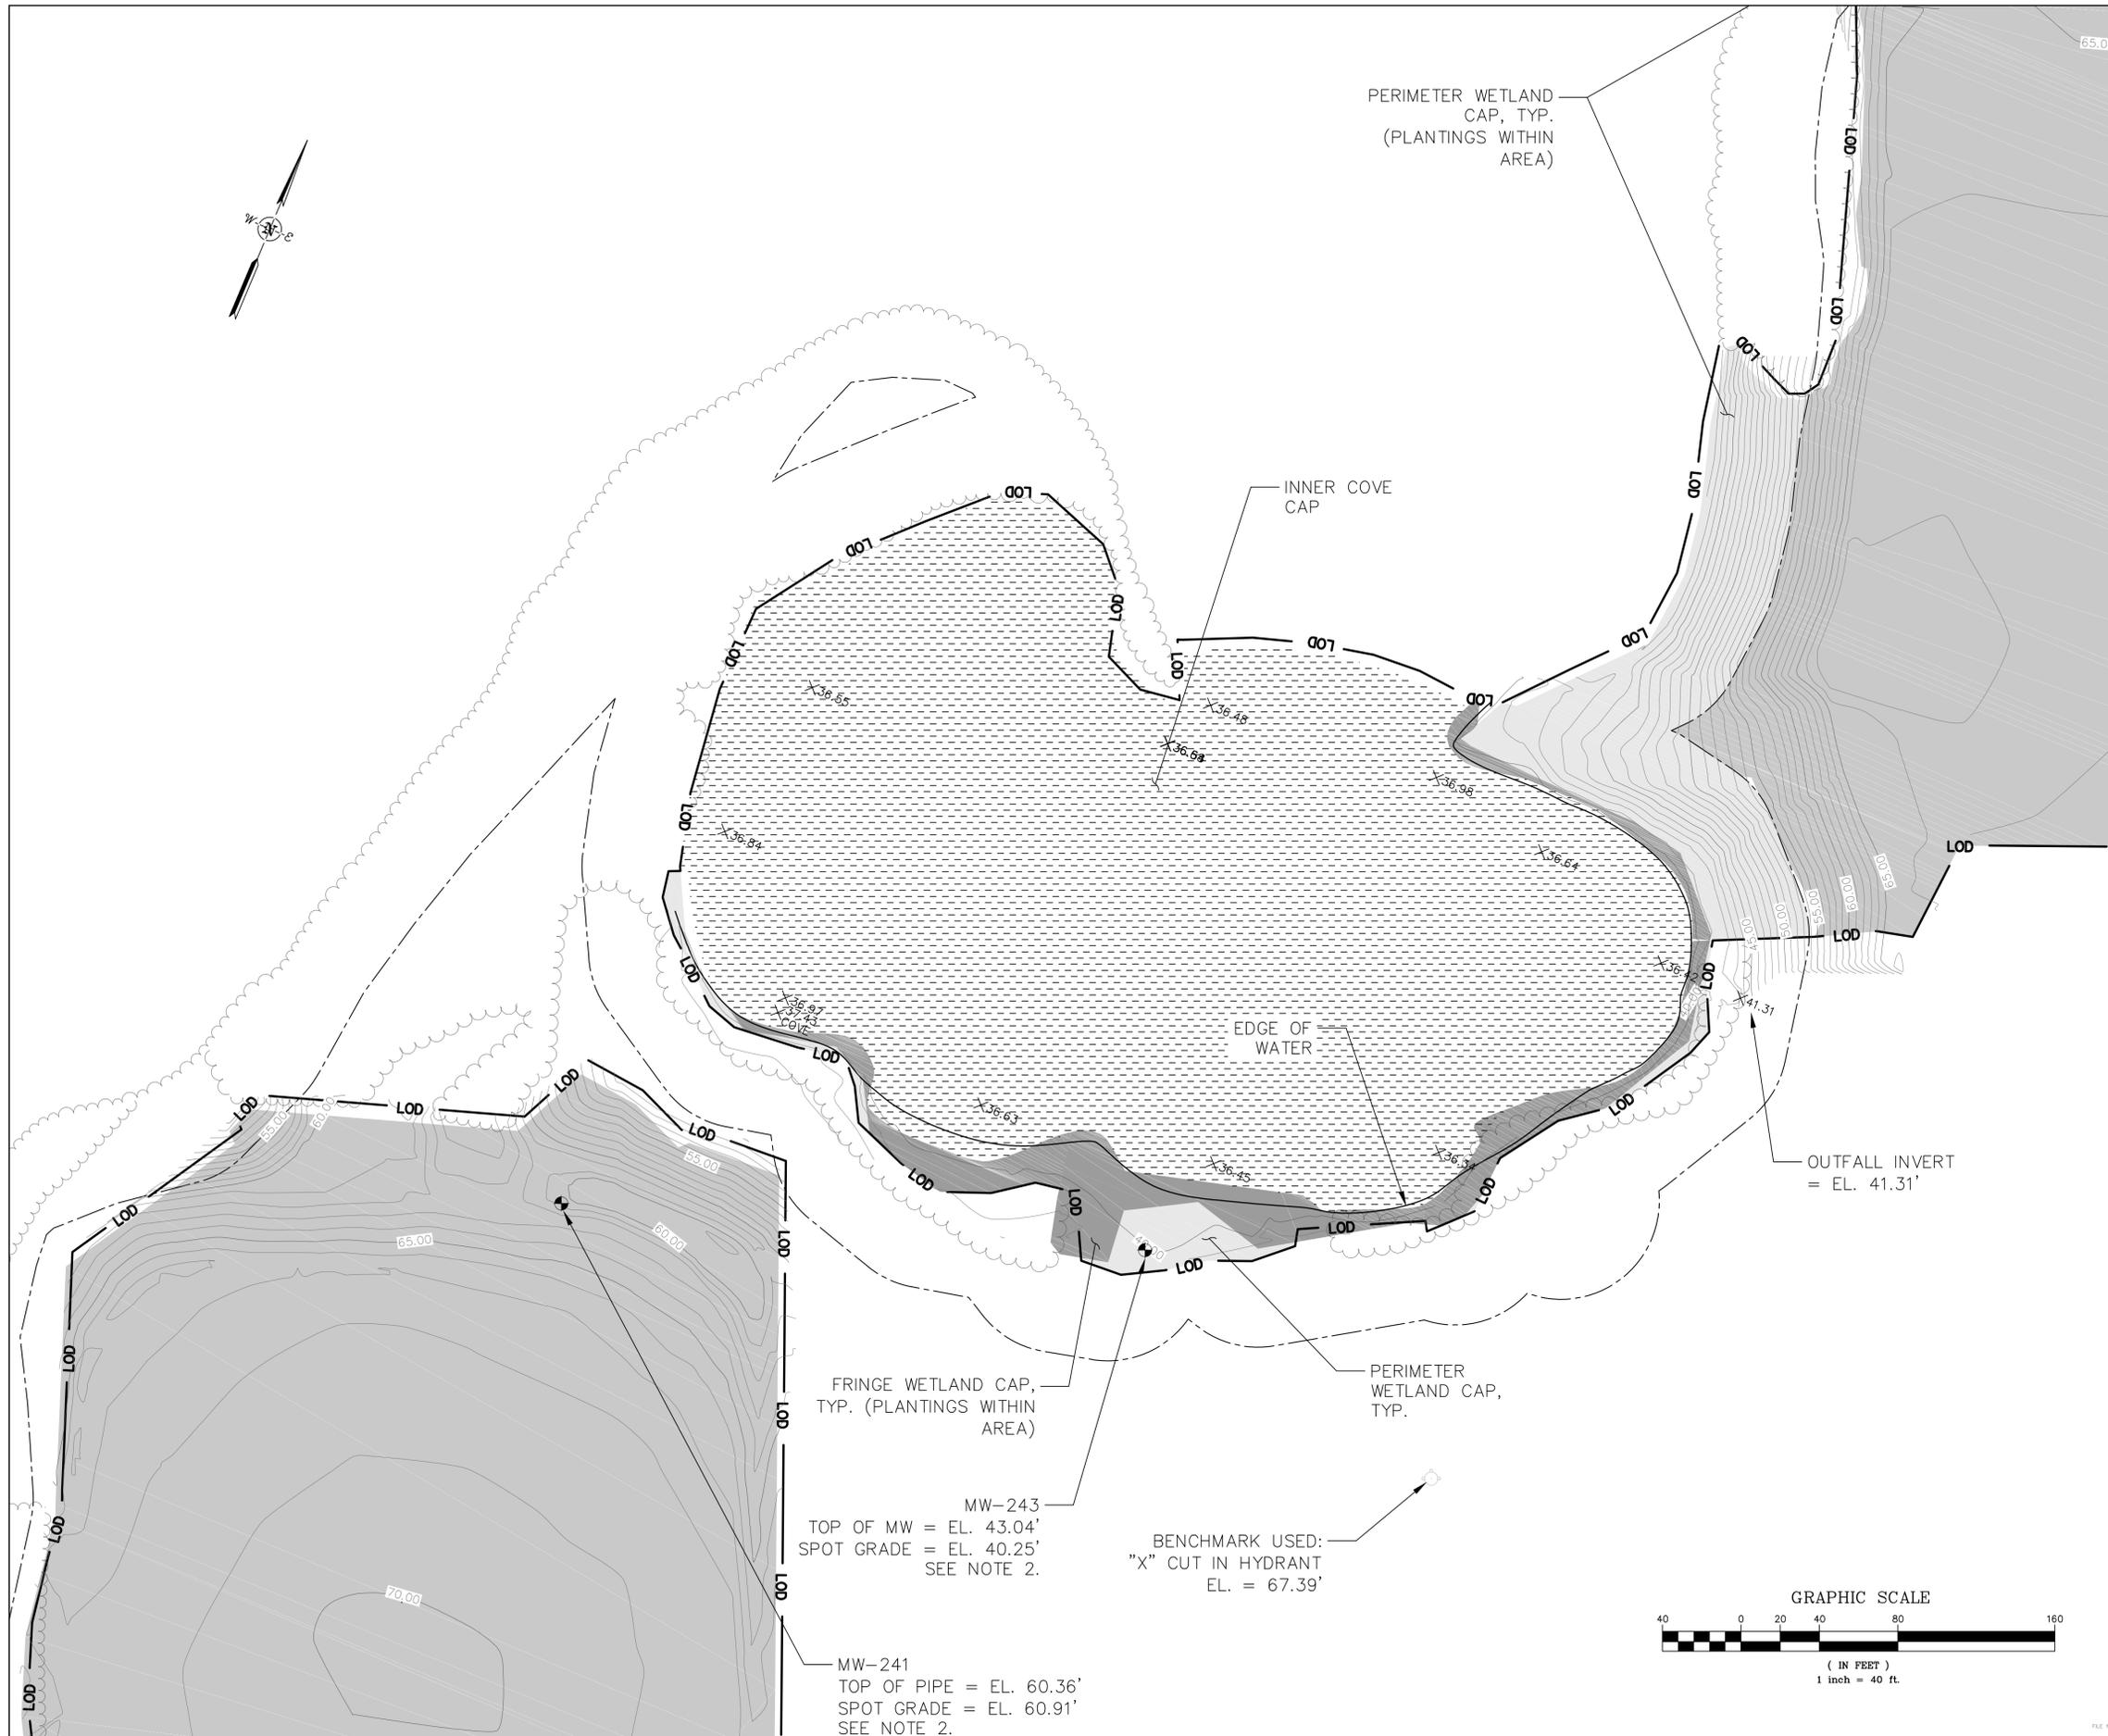

LEGEND

- 60.00 — AS-BUILT MAJOR CONTOUR
- AS-BUILT MINOR CONTOUR
- - - 50' PERIMETER WETLAND BUFFER
- LOD** LIMIT OF DISTURBANCE
- ~~~~~ TREELINE
- ⊗ 60.00 SPOT GRADE IN COVE
- ⊗ MONITORING WELL
- █ UPLAND CAP
- █ PERIMETER WETLAND CAP
- █ FRINGE WETLAND CAP
- █ INNER COVE CAP


NOTES:

1. AS-BUILT DATA WAS RECORDED BY CHARTER CONTRACTING COMPANY, L.L.C. ON DECEMBER 17, 2015, JANUARY 13, 2016, AND JANUARY 29, 2016 USING A NUBBLE GPS ROVER. SURVEY BASED ON THE RHODE ISLAND NAD83 STATE COORDINATE SYSTEM. BENCHMARK USED FOR SURVEY CONTROL WAS "X" CUT INTO HYDRANT AT ELEVATION 67.39'.
2. LOCATIONS AND ELEVATIONS OF MONITORING WELLS MW-241 AND MW-243 WERE SURVEYED ON JANUARY 29, 2016 BY CHARTER. MW-241 ELEVATION SHOWN REPRESENTS TOP OF PIPE. MW-243 WAS LOCKED AND THE ELEVATION SHOWN REPRESENTS THE WELL CAP.

FIGURE 2
PARCEL C-1 (PHASE II AREA) AS-BUILT PLAN
 TEXTRON FORMER GORHAM SITE
 PROVIDENCE, RHODE ISLAND
 FEBRUARY 1, 2016

Charter PROJECT #: 2-1244
 DRAWN BY: S. GRAY
 500 HARRISON AVE. APPROVED BY: P. LEFANTI
 BOSTON, MA 02118
 857.246.6800

DATE	REVISIONS

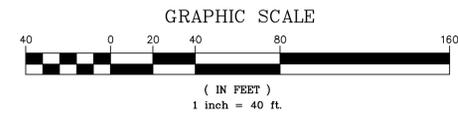




LEGEND

— 60.00 —	AS-BUILT MAJOR CONTOUR
— — — — —	AS-BUILT MINOR CONTOUR
- - - - -	50' PERIMETER WETLAND BUFFER
— LOD —	LIMIT OF DISTURBANCE
~~~~~	TREELINE
⊗ 60.00	SPOT GRADE IN COVE
⊗	MONITORING WELL
■	UPLAND CAP
■	PERIMETER WETLAND CAP
■	FRINGE WETLAND CAP
■	INNER COVE CAP

- NOTES:**
- AS-BUILT DATA WAS RECORDED BY CHARTER CONTRACTING COMPANY, L.L.C. ON DECEMBER 17, 2015, JANUARY 13, 2016, AND JANUARY 29, 2016 USING A NUBBLE GPS ROVER. SURVEY BASED ON THE RHODE ISLAND NAD83 STATE COORDINATE SYSTEM. BENCHMARK USED FOR SURVEY CONTROL WAS "X" CUT INTO HYDRANT AT ELEVATION 67.39'.
  - LOCATIONS AND ELEVATIONS OF MONITORING WELLS MW-241 AND MW-243 WERE SURVEYED ON JANUARY 29, 2016 BY CHARTER. MW-241 ELEVATION SHOWN REPRESENTS TOP OF PIPE. MW-243 WAS LOCKED AND THE ELEVATION SHOWN REPRESENTS THE WELL CAP.

**FIGURE 3**  
**PARCEL C-1 (PHASE III AREA) AS-BUILT PLAN**  
 TEXTRON FORMER GORHAM SITE  
 PROVIDENCE, RHODE ISLAND  
 FEBRUARY 1, 2016

	PROJECT #:	2-1244
	DRAWN BY:	S. GRAY
	500 HARRISON AVE.	APPROVED BY: P. LEFANTI
	BOSTON, MA 02118 857.246.6800	

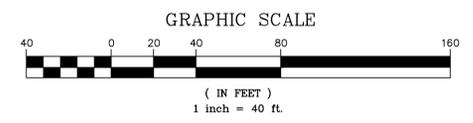

DATE	REVISIONS